

LEGEND



△ CP - Computed Point	⊠ AXLE
● NIR - New Iron Rod	⊠ ANG-IR
○ EIP - Existing Iron Pipe	□ C/MON
⊗ EIR - Existing Iron Rod	⊠ R/W MONUMENT
▲ PK SET	⊠ R/W MARKER
▲ PK FOUND	— OHE - Overhead Electric/Utilities
⊗ EIR W/CAP	— Fence
⊗ RRS FOUND	— Right of Way
⊗ RRS SET	— Adjacent Property Lines
⊠ STAKE FOUND	— Property Line
⊠ STAKE SET	— Easement Line
⊠ POWER POLE	— Gravel Road/Path
⊠ Sills	— Paved Road/Path
⊠ Pool	⊠ Rip Rap
— 5' Contour	⊠ Gravel
— 1' Contour	— Root Wad
⊠ Rock Vane	— Log Weir/ Vane
⊠ Double Rock Cross Vane	— Rock Cross Vane
⊠ Rifle Area	

Sherie M. Willard

LEVEL CROSS SURVEYING, PLLC
 668 Marsh Country Lane
 Randleman, N.C. 27317
 Ph. (336) 495-1713
 Fax (336) 495-1745

Note:
 Shaded background portion of drawing is for information only and has not been verified as As-Built. Shaded base drawing for this survey was provided by Buck Engineering.

Survey Dates
 September 2007 to November 2007
 Project No. 1207006 IMF

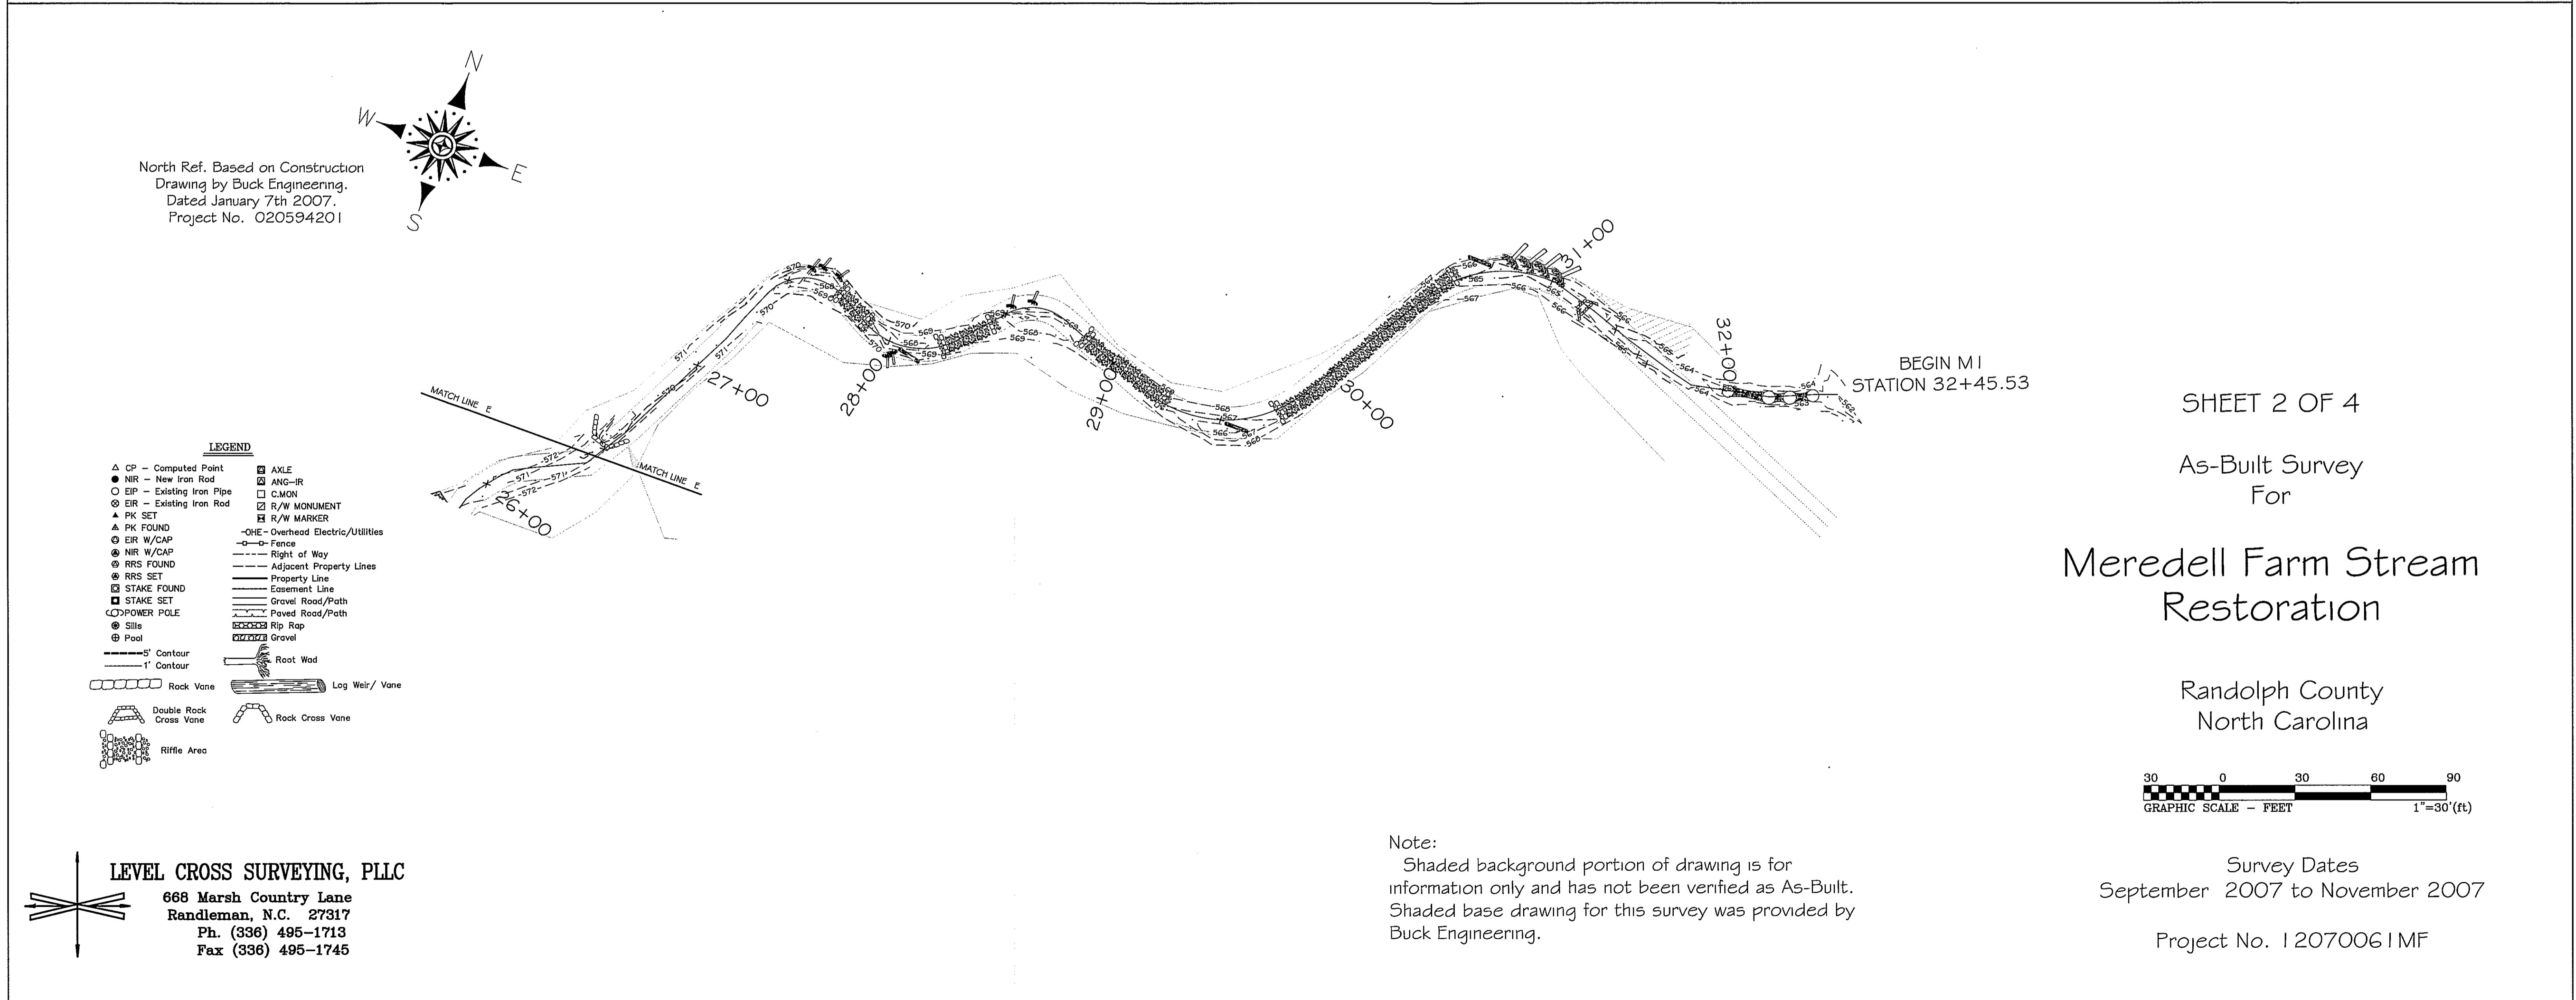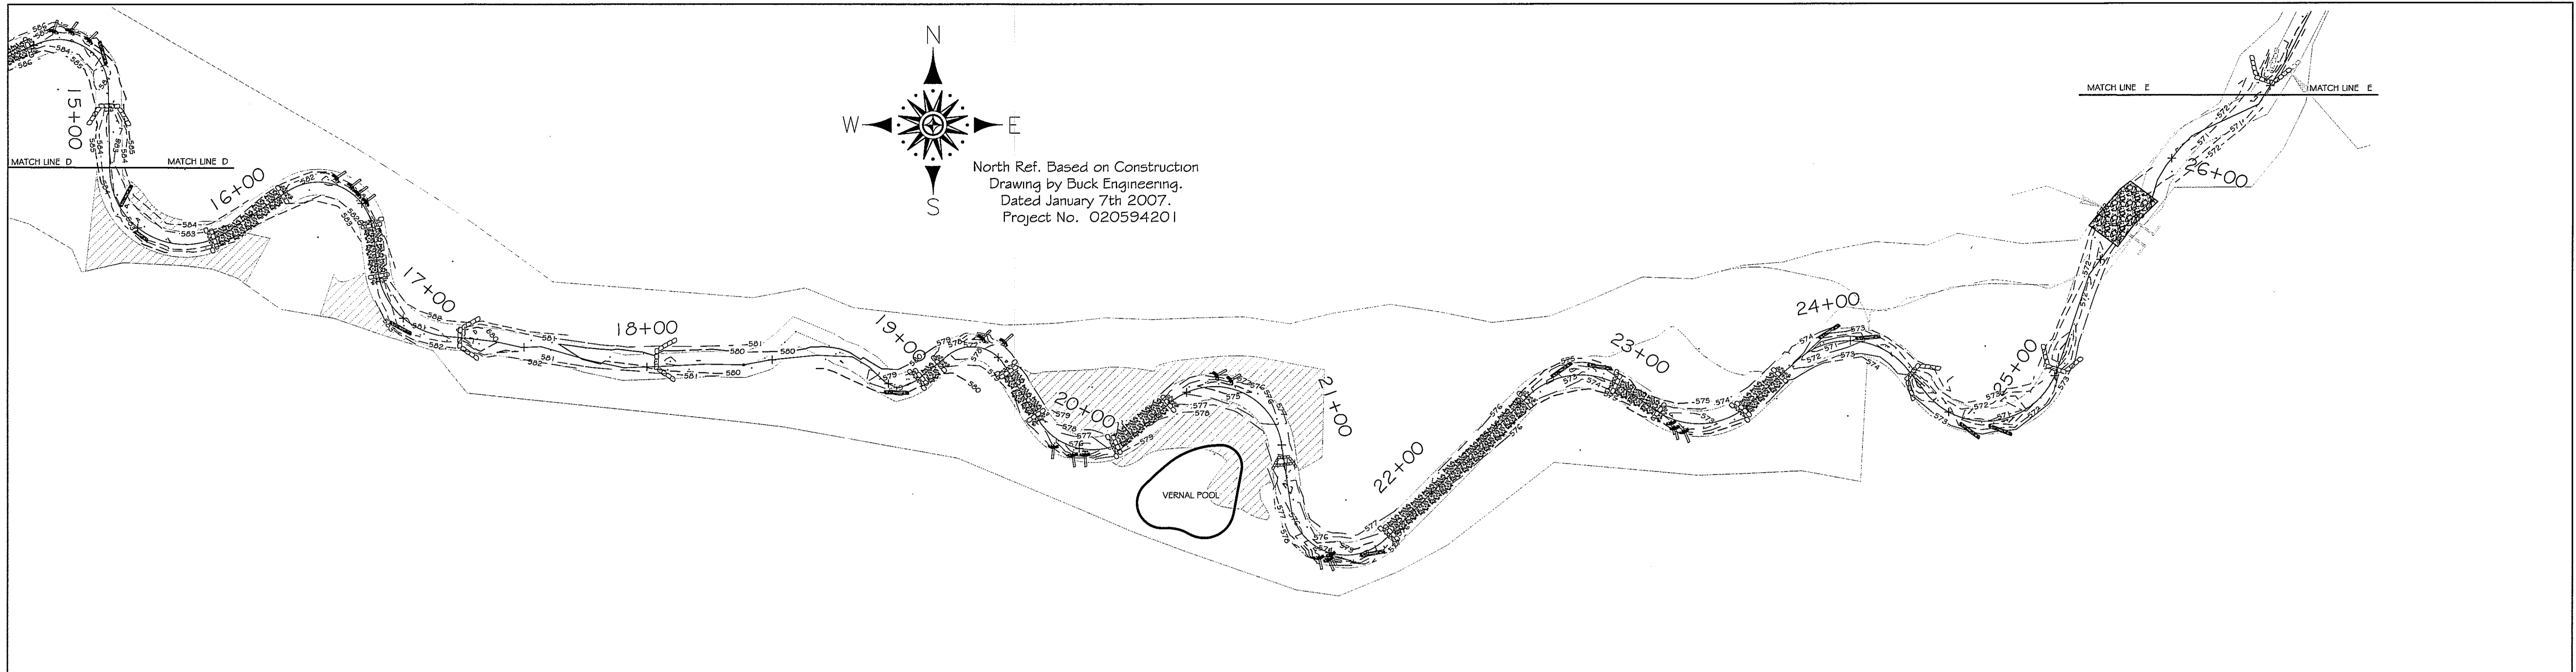


SHEET 2 OF 4

As-Built Survey
For

Meredell Farm Stream Restoration

Randolph County
North Carolina

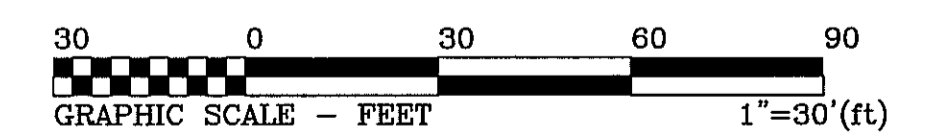

Note:


Shaded background portion of drawing is for information only and has not been verified as As-Built. Shaded base drawing for this survey was provided by Buck Engineering.

Survey Dates
September 2007 to November 2007

Project No. 12070061M



LEVEL CROSS SURVEYING, PLLC

668 Marsh Country Lane
Randleman, N.C. 27317
Ph. (336) 495-1713
Fax (336) 495-1745

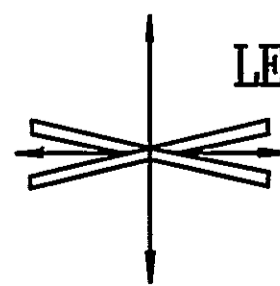

LEGEND

- | | |
|----------------------------|-------------------------------------|
| △ CP - Computed Point | □ AXLE |
| ● NIR - New Iron Rod | □ ANG-IR |
| ○ EIP - Existing Iron Pipe | □ C.MON |
| ⊙ EIR - Existing Iron Rod | □ R/W MONUMENT |
| ▲ PK SET | □ R/W MARKER |
| ▲ PK FOUND | — ONE - Overhead Electric/Utilities |
| ⊙ EIR W/CAP | — Fence |
| ⊙ NIR W/CAP | — Right of Way |
| ⊙ RRS FOUND | — Adjacent Property Lines |
| ⊙ RRS SET | — Property Line |
| ⊙ STAKE FOUND | — Easement Line |
| ⊙ STAKE SET | — Gravel Road/Path |
| ⊙ POWER POLE | — Paved Road/Path |
| ⊙ Silt | — Rip Rap |
| ⊙ Pool | — Gravel |
| — 5' Contour | — Root Wad |
| — 1' Contour | — Lag Weir/ Vane |
| — Rock Vane | — Double Rock Cross Vane |
| — Double Rock Cross Vane | — Rock Cross Vane |
| — Riffle Area | |

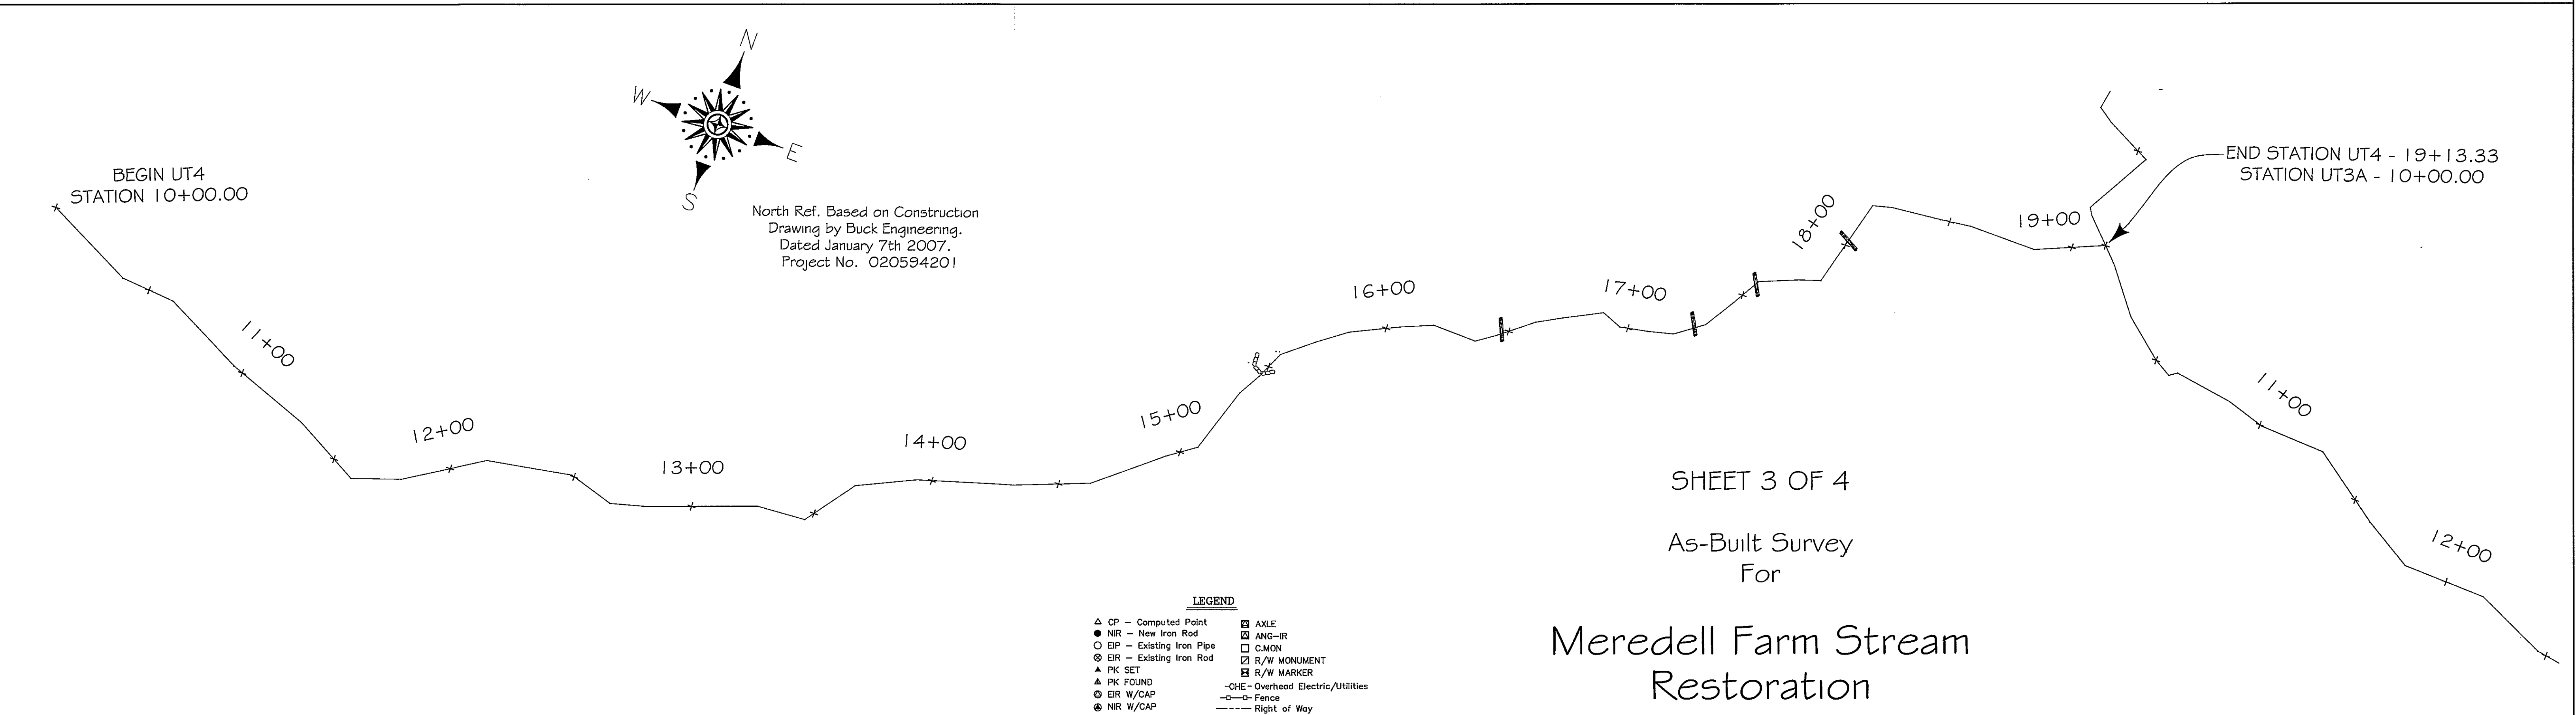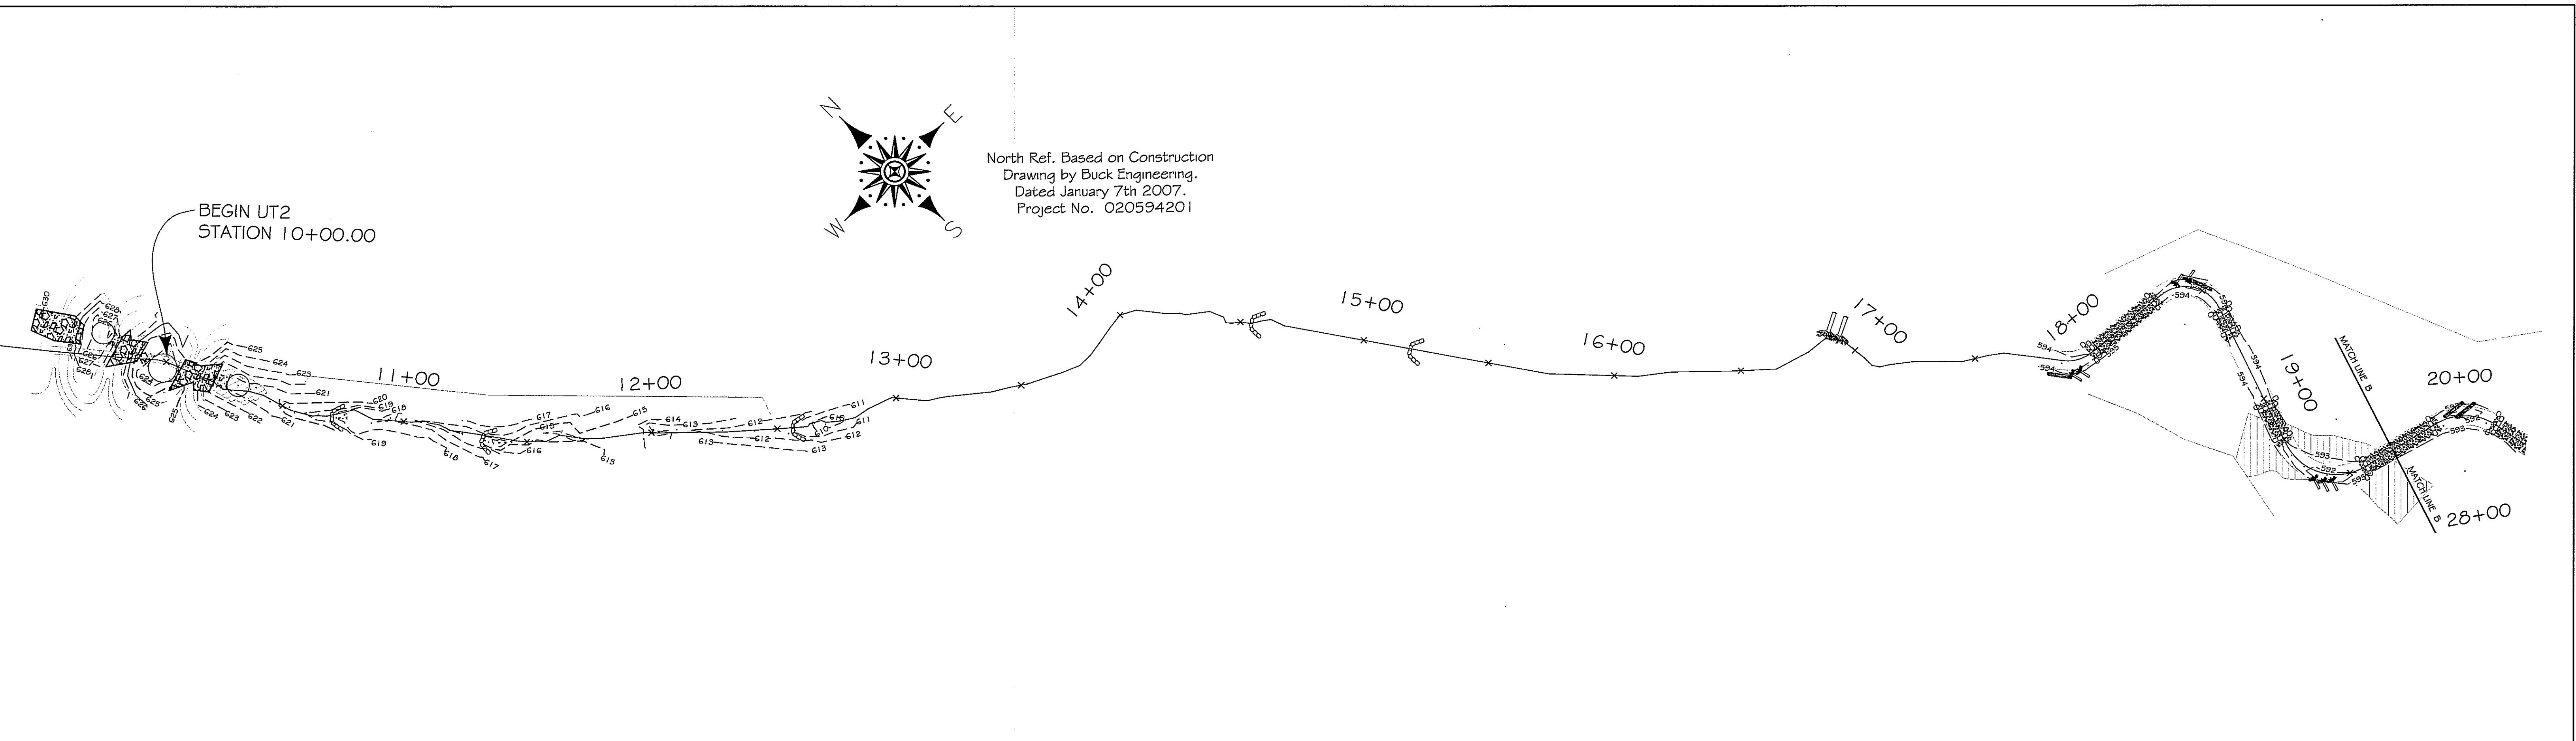

SHEET 3 OF 4

As-Built Survey
For

Meredell Farm Stream Restoration

Randolph County
North Carolina


Survey Dates
September 2007 to November 2007

Project No. 120700G1MF


Note:
Shaded background portion of drawing is for information only and has not been verified as As-Built. Shaded base drawing for this survey was provided by Buck Engineering.

LEGEND

△ CP - Computed Point	☒ AXLE
● NIR - New Iron Rod	☒ ANG-IR
○ EIP - Existing Iron Pipe	□ C.MON
⊗ EIR - Existing Iron Rod	☒ R/W MONUMENT
▲ PK SET	☒ R/W MARKER
▲ PK FOUND	-OHE - Overhead Electric/Utilities
⊗ EIR W/CAP	-D-D Fence
⊗ NIR W/CAP	- - - Right of Way
⊗ RRS FOUND	- - - Adjacent Property Lines
⊗ RRS SET	- - - Property Line
⊗ STAKE FOUND	- - - Easement Line
⊗ STAKE SET	- - - Gravel Road/Path
⊗ POWER POLE	- - - Paved Road/Path
⊗ Sills	▨ Rip Rap
⊗ Pool	▨ Gravel
--- 5' Contour	Root Wad
--- 1' Contour	Log Weir/ Vane
⊗ Rock Vane	⊗ Rock Cross Vane
⊗ Double Rock Cross Vane	⊗ Riffle Area

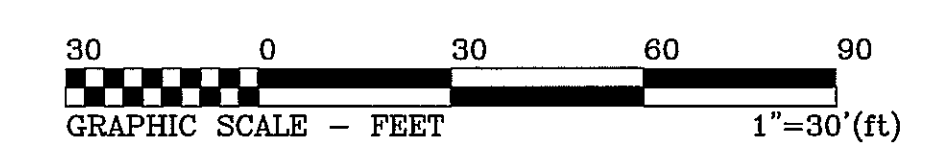


LEVEL CROSS SURVEYING, PLLC
668 Marsh Country Lane
Randleman, N.C. 27317
Ph. (336) 495-1713
Fax (336) 495-1745

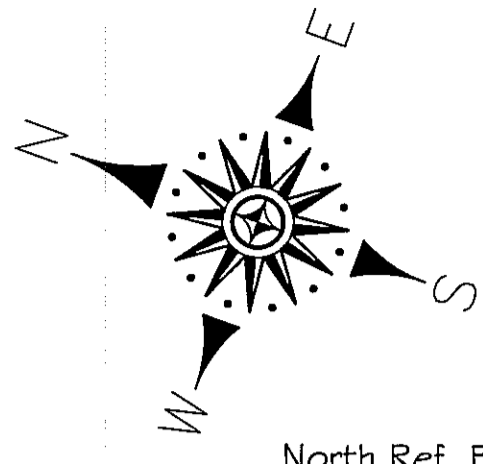


North Ref. Based on Construction Drawing by Buck Engineering. Dated January 7th 2007. Project No. 020594201

BEGIN STATION UT5 - 10+00.00

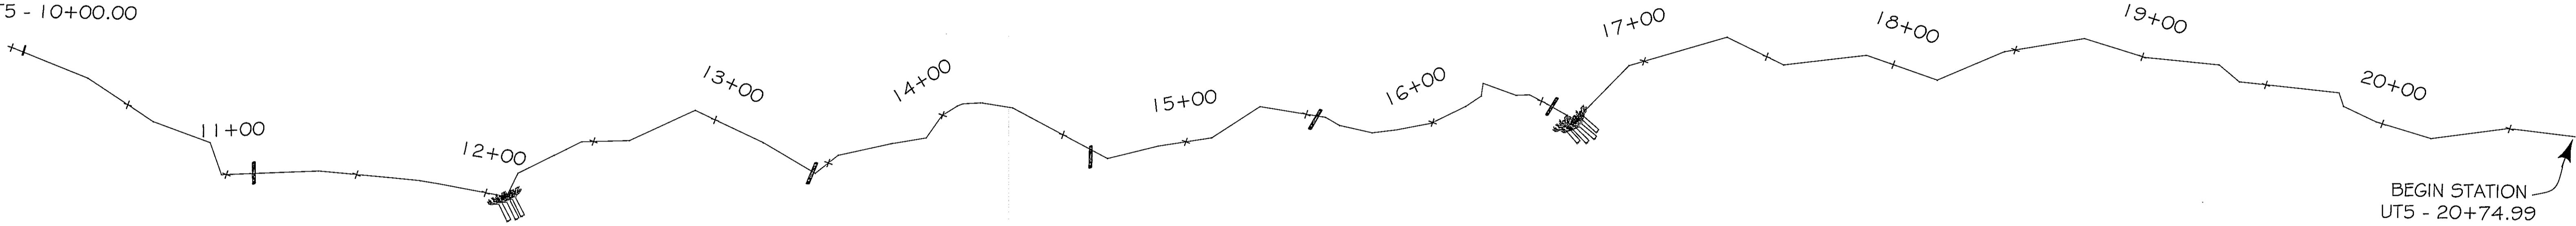


BEGIN STATION UT5 - 20+74.99

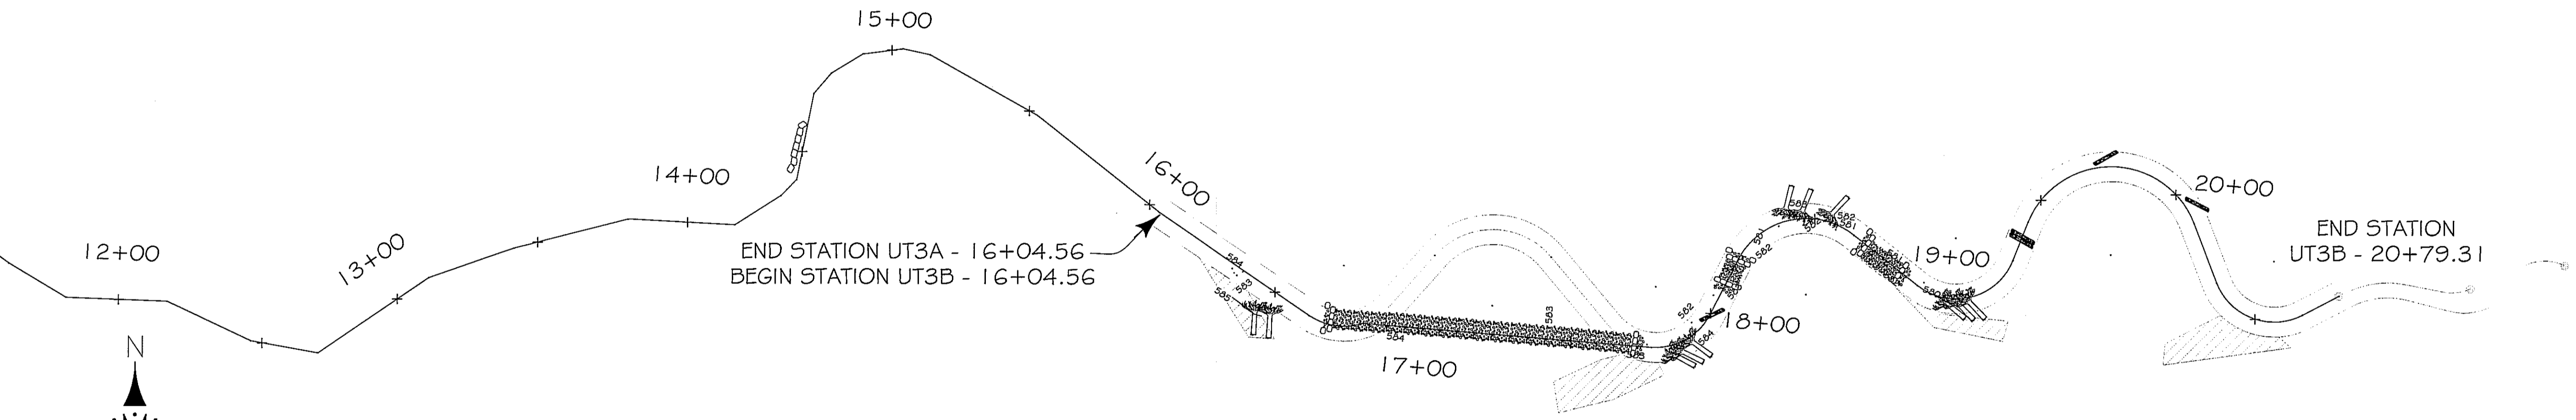

END STATION UT3A - 16+04.56
BEGIN STATION UT3B - 16+04.56

END STATION UT3B - 20+79.31

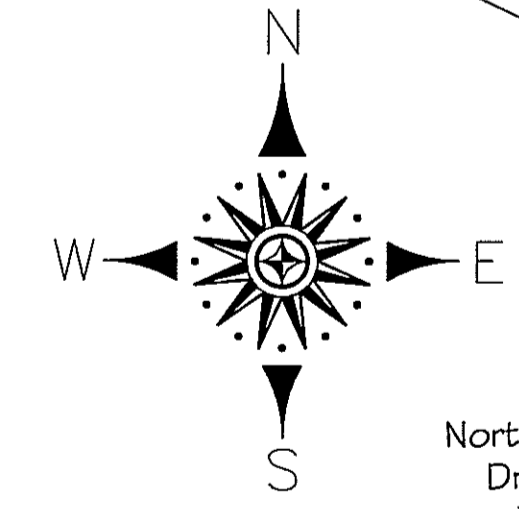

North Ref. Based on Construction Drawing by Buck Engineering. Dated January 7th 2007. Project No. 020594201

LEGEND

△ CP - Computed Point	▣ AXLE
● NIR - New Iron Rod	▣ ANG-IR
○ EIP - Existing Iron Pipe	▣ C/MON
⊙ EIR - Existing Iron Rod	▣ R/W MONUMENT
▲ PK SET	▣ R/W MARKER
▲ PK FOUND	— OHE - Overhead Electric/Utilities
⊙ EIR W/CAP	— Fence
⊙ NIR W/CAP	— Right of Way
⊙ RRS FOUND	— Adjacent Property Lines
⊙ RRS SET	— Property Line
⊙ STAKE FOUND	— Easement Line
⊙ STAKE SET	— Gravel Road/Path
⊙ POWER POLE	— Paved Road/Path
⊙ Sills	— Rip Rap
⊙ Pool	— Gravel
— 5' Contour	— Root Wad
— 1' Contour	— Log Weir/Vane
— Rock Vane	— Rock Vane
— Double Rock Cross Vane	— Rock Cross Vane
— Riffle Area	

SHEET 4 OF 4

As-Built Survey For

Meredell Farm Stream Restoration

Randolph County
North Carolina

Survey Dates
September 2007 to November 2007

Project No. 12070061MF

LEVEL CROSS SURVEYING, PLLC
668 Marsh Country Lane
Randleman, N.C. 27317
Ph. (336) 495-1713
Fax (336) 495-1745

Note:
Shaded background portion of drawing is for information only and has not been verified as As-Built. Shaded base drawing for this survey was provided by Buck Engineering.

