


STONEBRIDGE STREAM AS-BUILT PLANS

APRIL 2006

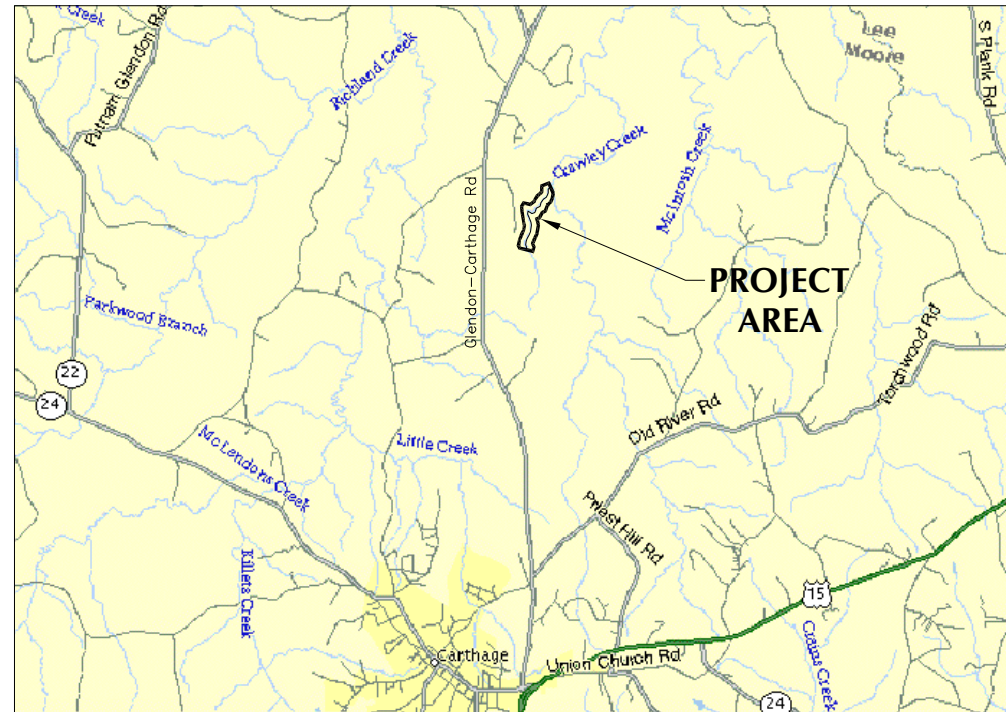

VICINITY MAP
NTS

ENVIRONMENTAL BANC & EXCHANGE, LLC

MANAGERS, BANKERS AND TRADERS OF
ENVIRONMENTAL RIGHTS

10055 RED RUN BOULEVARD, SUITE 130
OWINGS MILLS, MARYLAND 21117-4860



3101 JOHN HUMPHRIES WYND
RALEIGH, NC 27612
(919) 782-0495

