


ALAMANCE COUNTY
VICINITY MAP
NOT TO SCALE

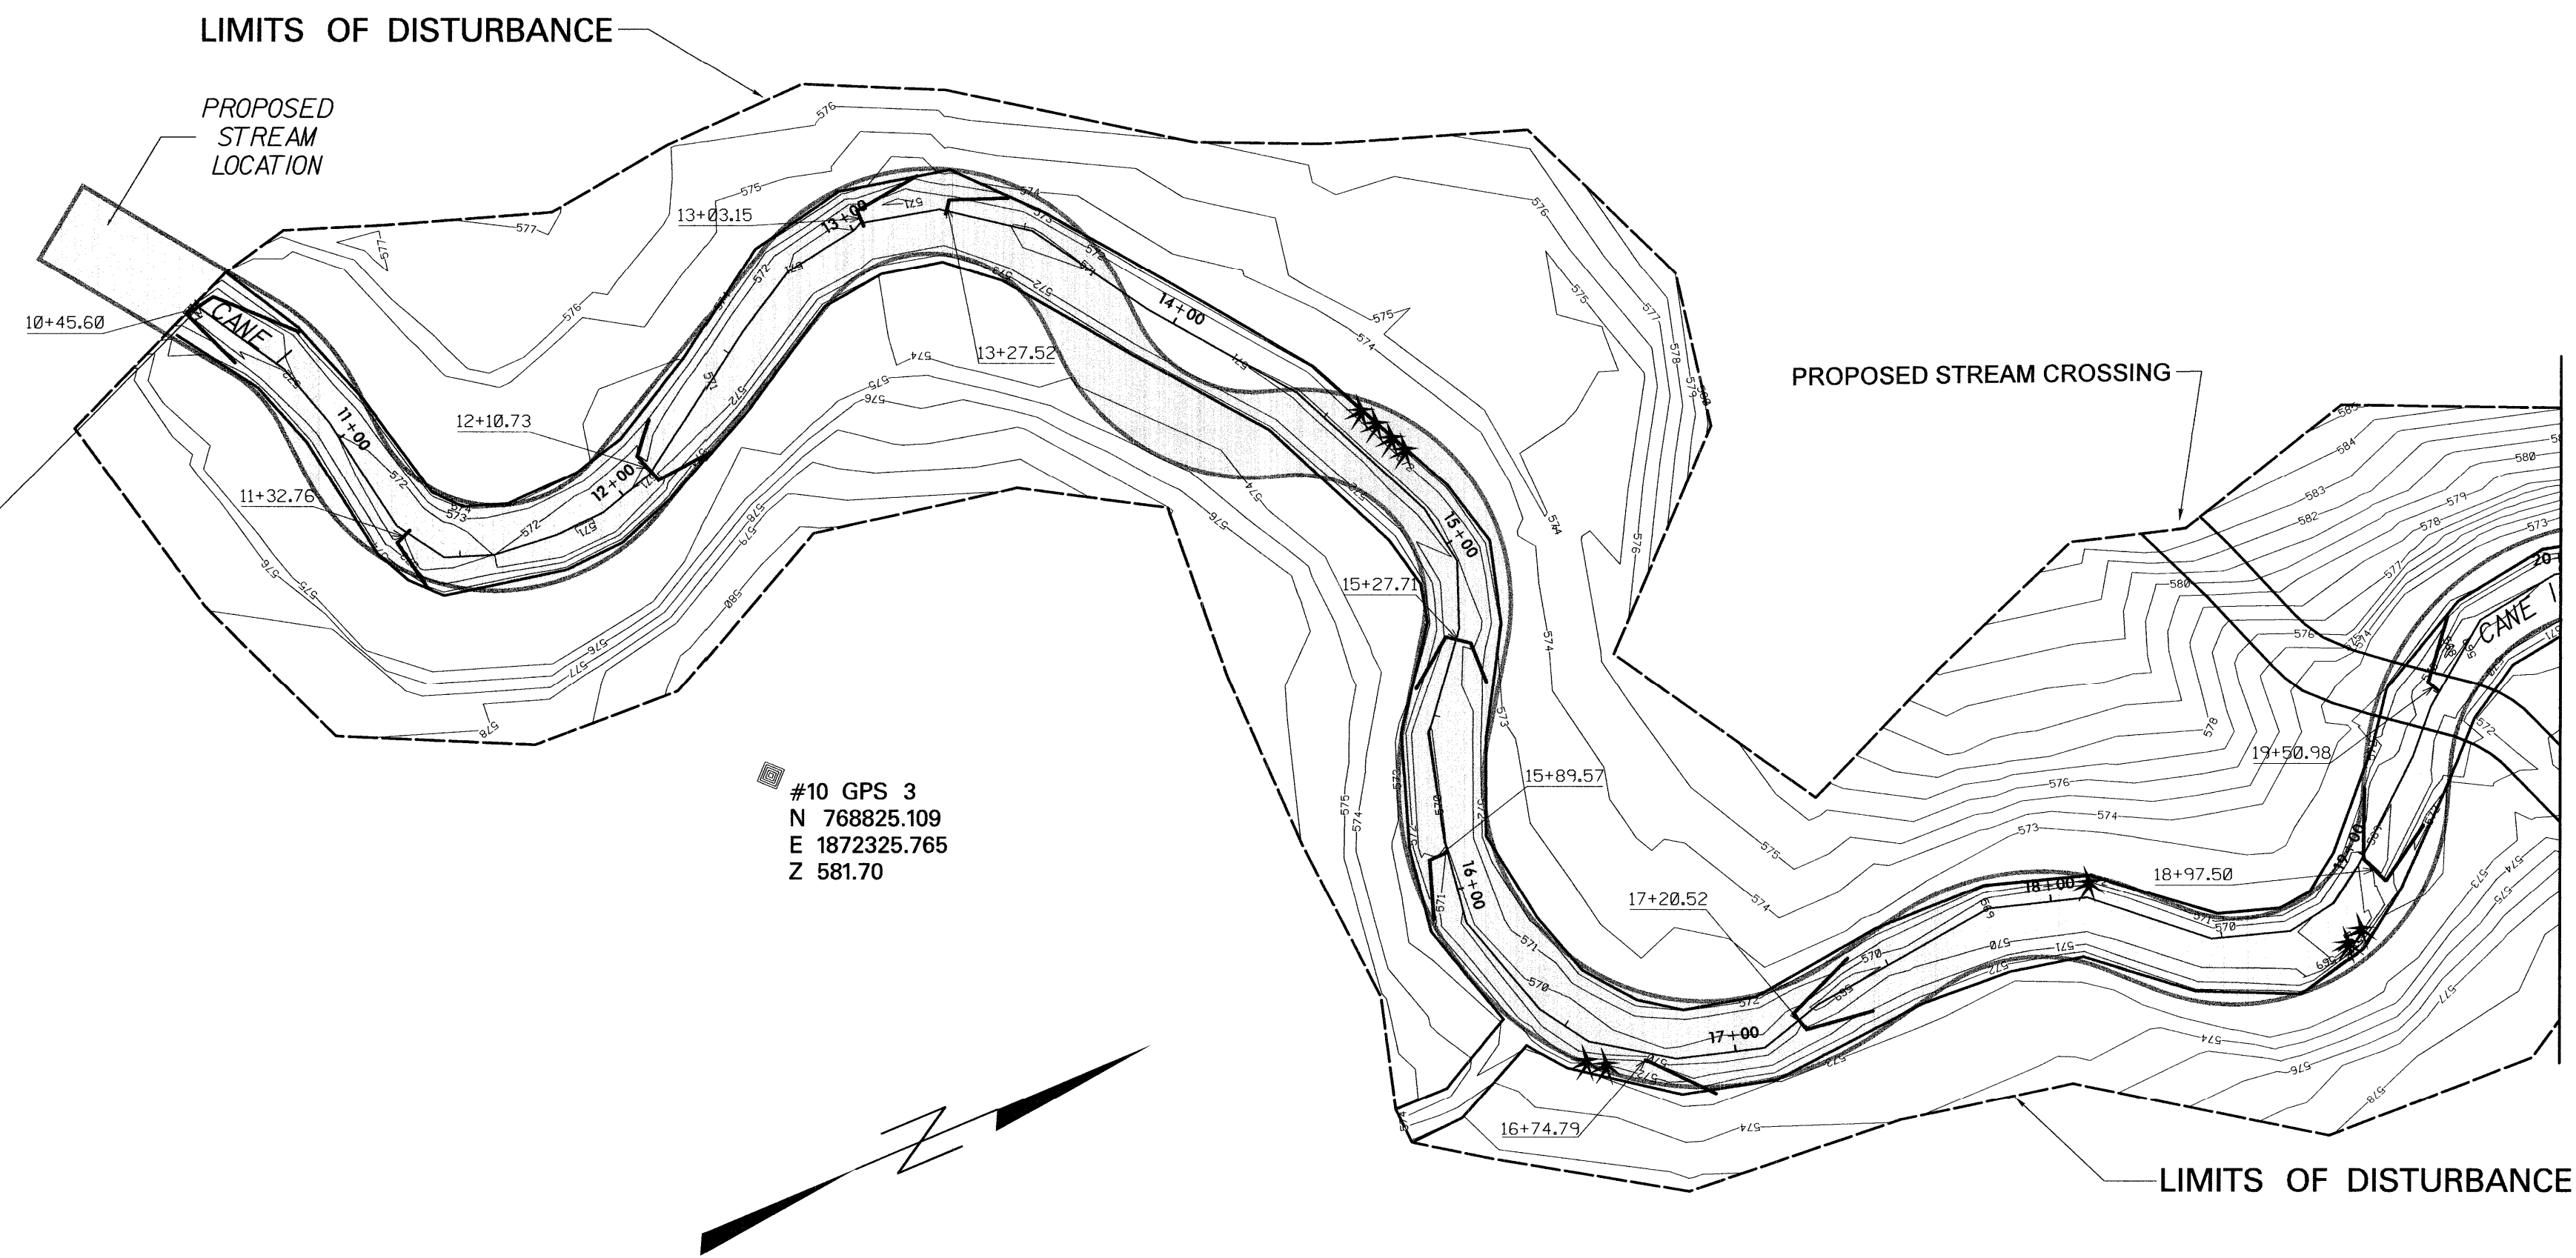


#11 GPS 4
N 768457.957
E 1872253.665
Z 593.28

291.85
N22°27'44"W


#10 GPS 3
N 768825.109
E 1872325.765
Z 581.70

- ROOT WAD
- ROCK CROSS VANE
- J-VANE

- NOTES:
- GPS COORDINATES WERE PROVIDED BY STANTEC CONSULTING SERVICES, INC. PROJECT REFERENCE #CMCCPF/02.
 - ROCK VANE STATIONS SHOWN ARE CENTERLINE AT HEAD OF STRUCTURE.
 - ROOT WADS ARE NOT TO SCALE.

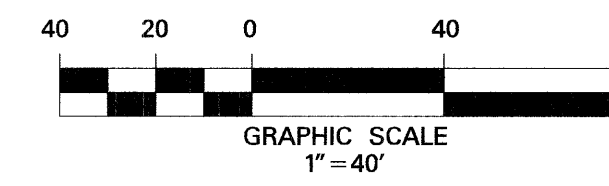

VERTICAL 1"=4'
HORIZONTAL 1"=40'

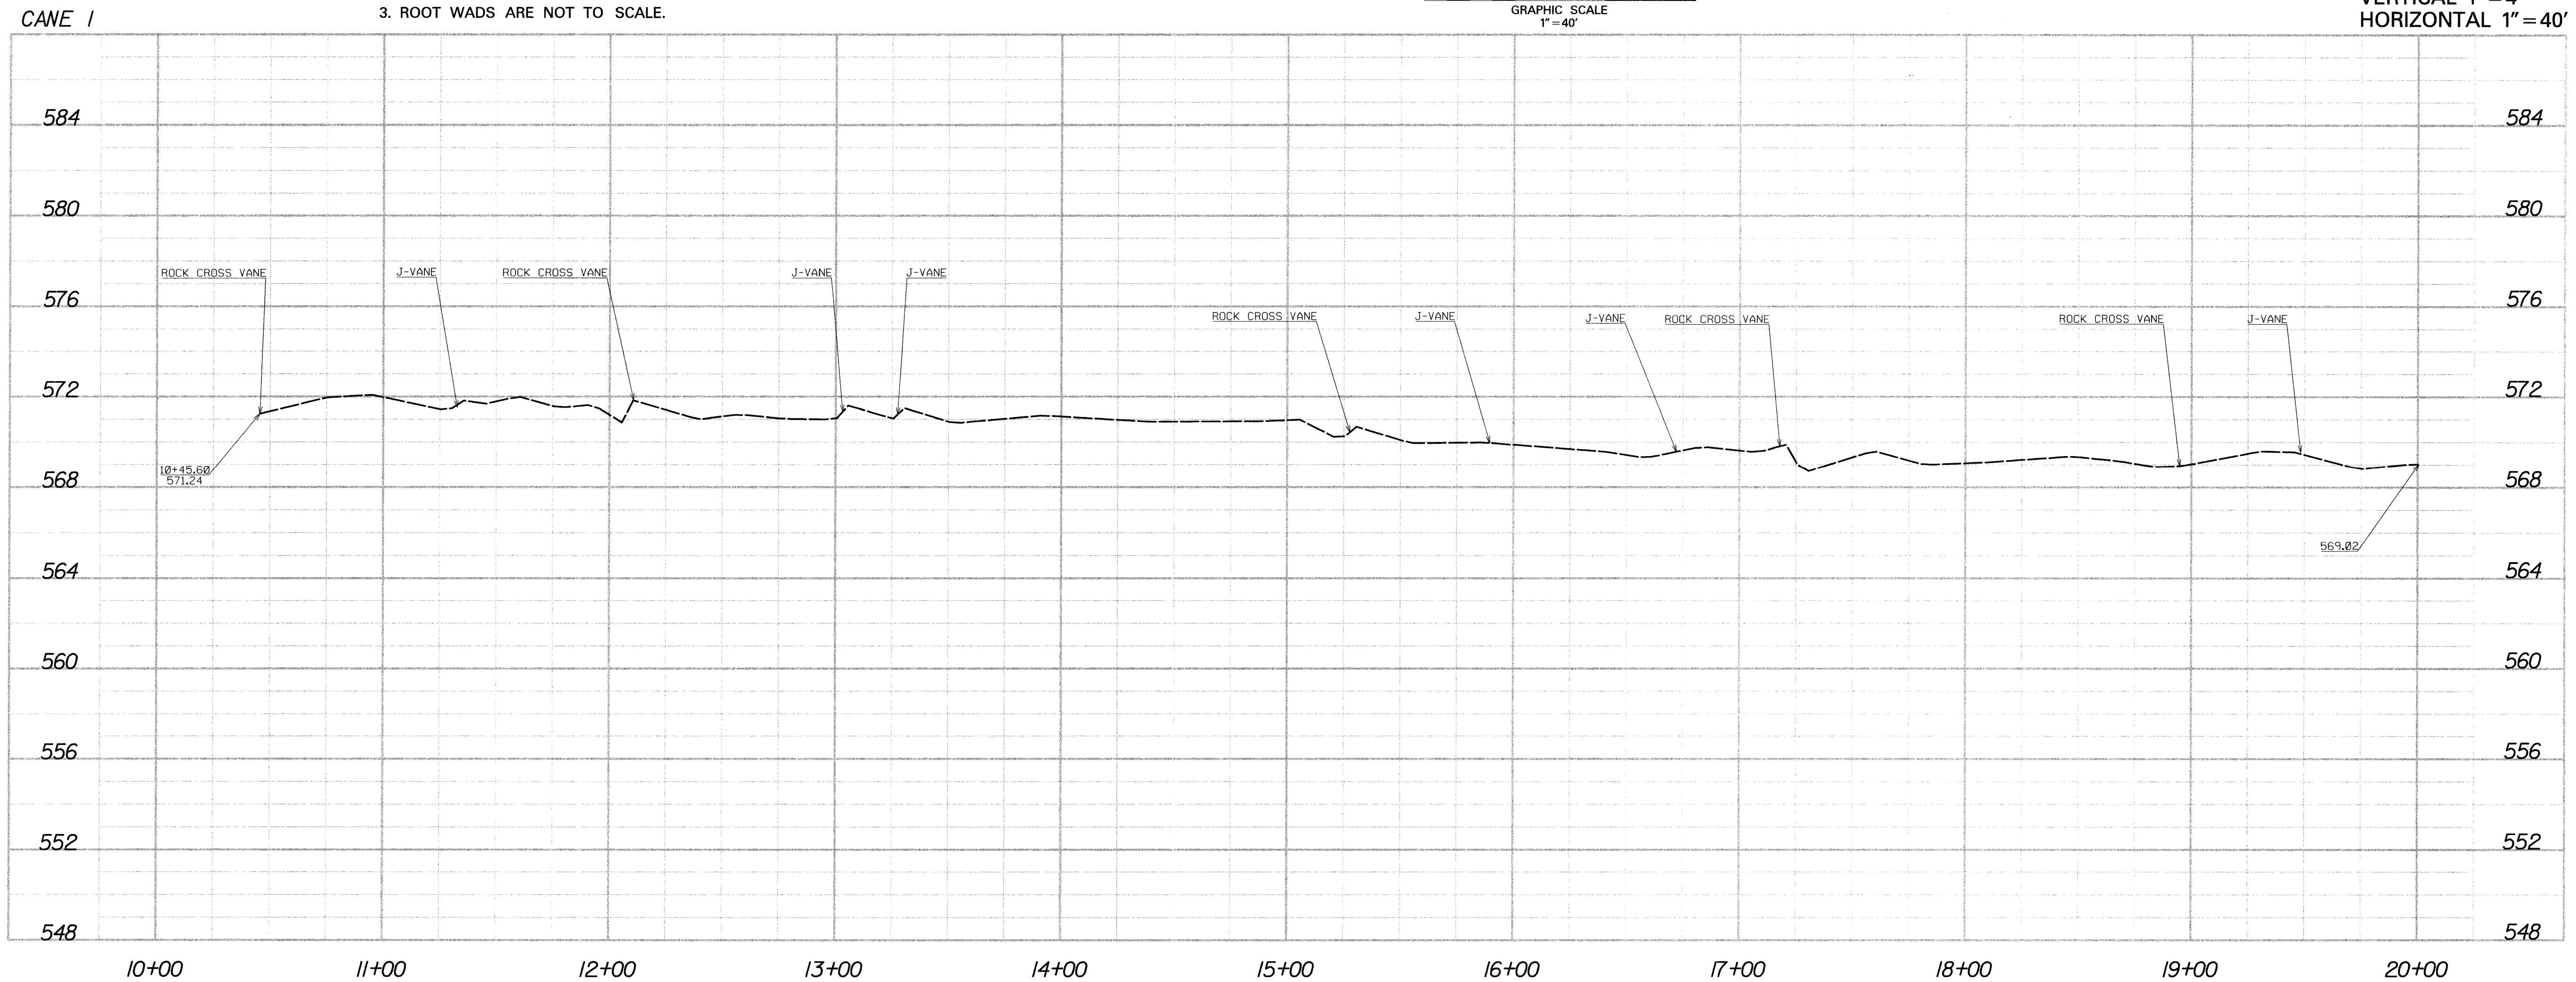

NO.	DATE	REVISIONS
1		
2		
3		
4		
5		
6		
7		
8		

UNNAMED TRIBUTARY
TO CANE CREEK
ALAMANCE COUNTY, NC, MCPHERSON PROPERTY

RESTORATION PLANS
ASBUILT

